


56 - Rutland 線改變職員建議:

- 建議用小巴服務, 俾更能配合乘客量和道路之幾何形狀
- 縮短路線, 俾改善頻密性 (由三十分鐘改為二十分鐘)
- 在 Executive Park 部份和沿 Visitacion Ave. 部份將告終止
- 在 Sawyer St. 和 Bayshore Blvd. 一段, 將在 Leland Ave. 而非 Sunnydale Ave. 行車

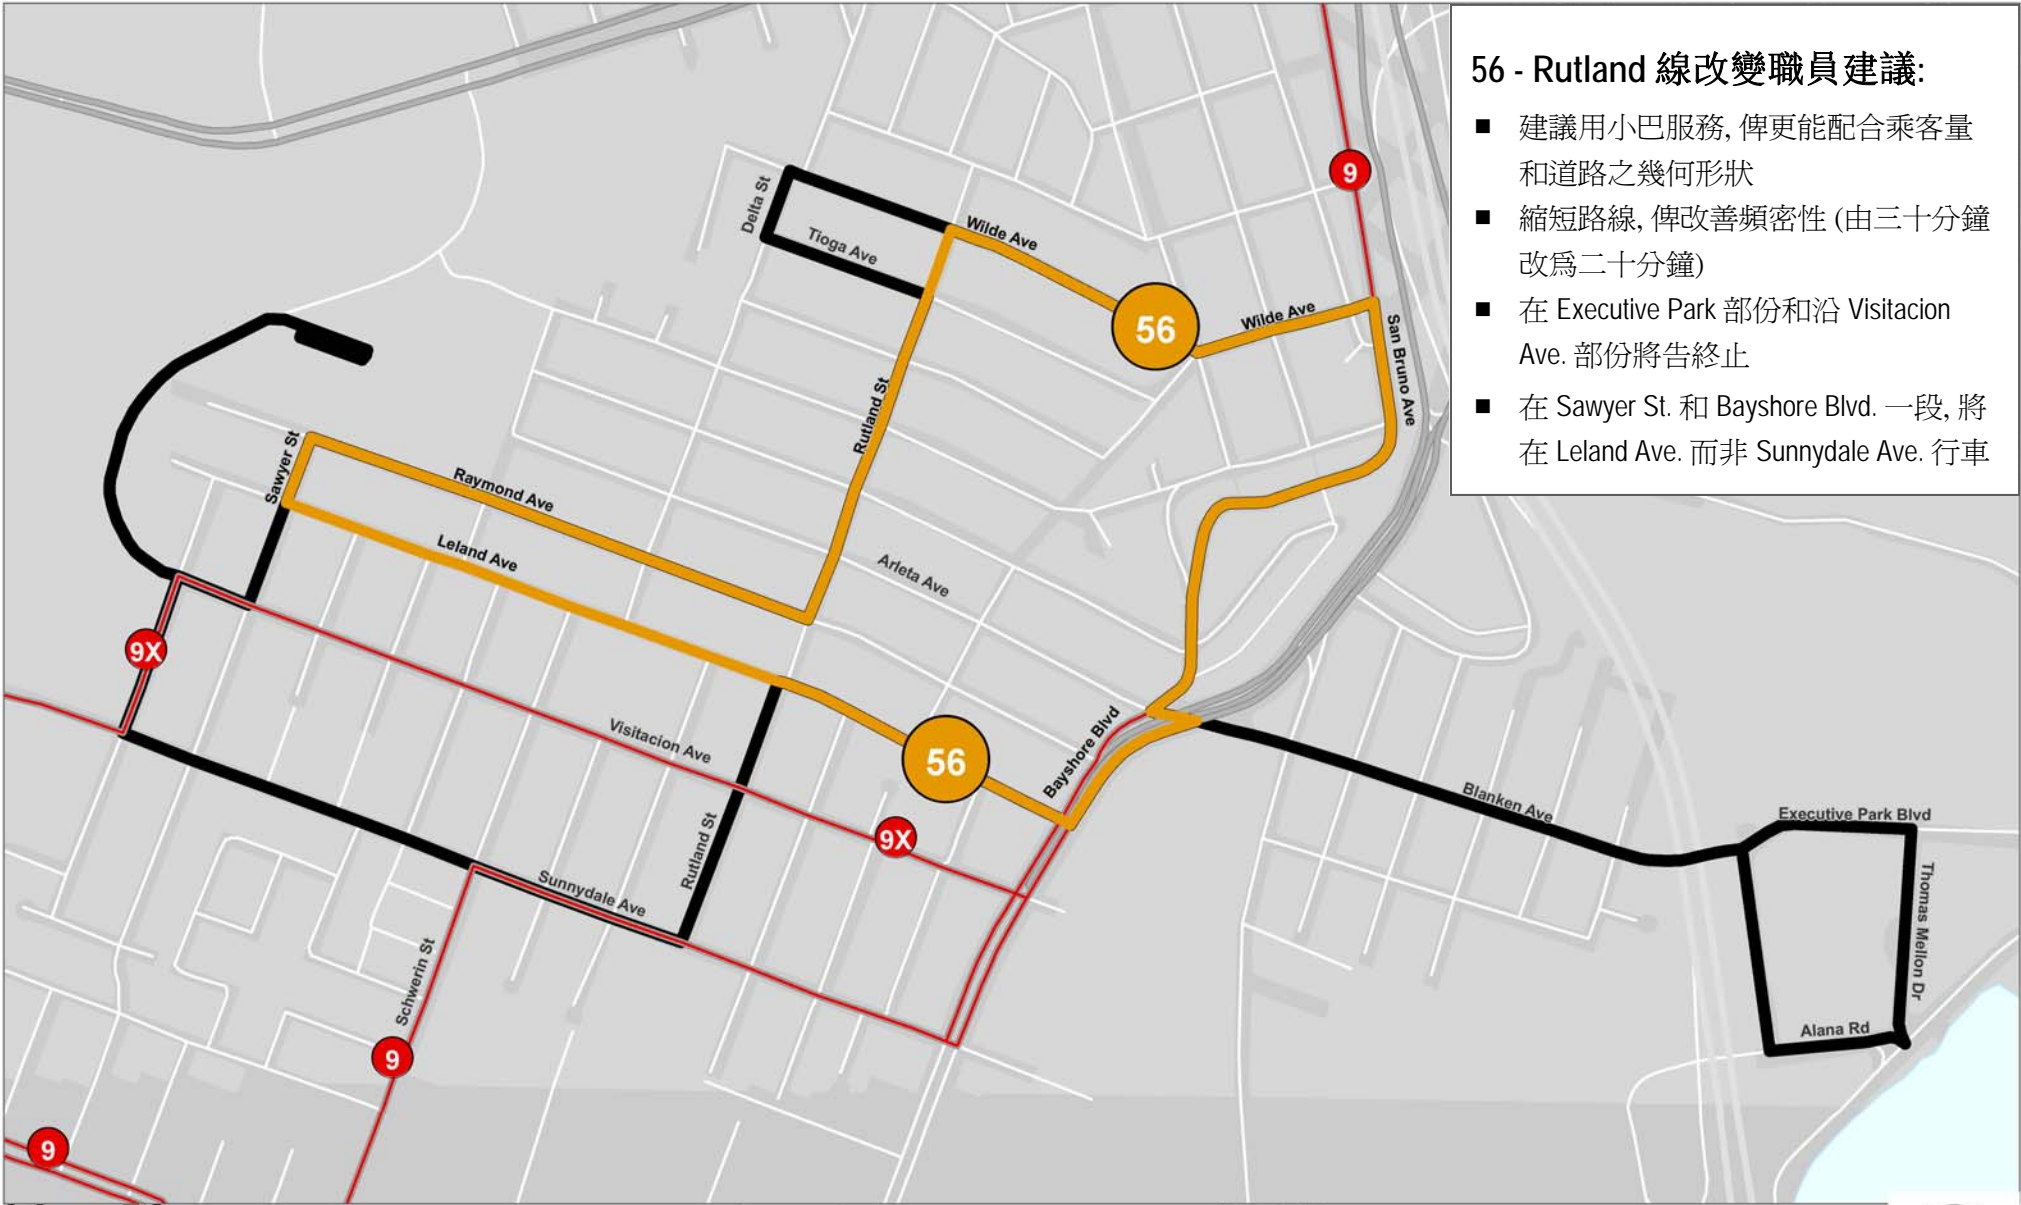

**Line 56
Recommended Route Alignment**

*Only the showcased route and related routes are shown in color. The rest of the recommended network is shown in gray.

Legend

- Yellow line: Recommended Route
- Red line: Segment would be covered by another recommended route
- Gray line: Recommended Bus and Rail Network
- Black line: Segment Proposed for Elimination
- Red circle: Muni Metro Stations
- Blue circle: BART Stations
- Purple circle: Caltrain Stations

Route Type

- Red line: Rapid
- Green line: Local
- Yellow line: Community
- Blue line: Specialized Services

SFMTA | Municipal Transportation Agency



Map Updated July 2008

